

**PURCHASING OFFICE**  
P.O. BOX 3371  
PHONE 813-247-8034  
FAX 813-247-0907

**David Gee, Sheriff**

HILLSBOROUGH COUNTY  
TAMPA, FLORIDA 33601

SUBJECT: RFP No. 24-08 SOC Wall / Fencing and Guardhouse

ADDENDUM: Number 3

DATE: February 16, 2009

MESSAGE: Please note and acknowledge the following changes are to be included under each section referenced for RFP No. 24-08:

Attached references to Construction Drawings, Sheet No. A1.1 & No. A5.1.

Attached Drawings 2-A1.1-1 and 2-A1.1-2. dated 2/13/09

Please note that this document hereby becomes a part of RFP No. 24-08 and without this complete document the bid is considered incomplete.

Sincerely,

**- SIGNATURE ON FILE -**

Stephen G. Crane  
Comptroller

Rañon & Partners, Inc., Architects  
515 Bay Street, Suite 200  
Tampa, Florida 33606-2701

Project: **SOC SECURITY WALL / FENCING and GUARDHOUSE  
CONSTRUCTION PROJECT  
HCSO Proposal Number 24-08  
R&P Project No. 0807L**

February 16, 2009

**ADDENDUM NO. 3**

To: All bidders of record and other parties to whom documents have been issued.

This Addendum forms part of the Contract Documents and modifies them as noted below. All bidders shall acknowledge receipt of this Addendum in the "Proposal" submitted to the Owner.

**I. REFER TO DRAWINGS**

**A. SHEET NO. A1.1**

1. Revise location of wall and fencing at SE corner of site per Drawing 2-A1.1-1.
2. Revise location of wall and fencing along East side of site per Drawing 2-A1.1-2.
3. Relocate existing sanitary sewer cleanout at North side of site in conflict with new wall and/or fence.

**B. SHEET NO. A5.1**

1. Elevation 5/A5.1; revise footing size and reinforcing as follows; 2'-6" x 2'-6" x 1'-0" with 3 - #5 with 90-degree hooks each way. Vertical dowels shall be as indicated on drawing.
2. Elevation 6/A5.1, footing for new wall shall be as indicated in Detail 4/A7.1. Footing size and reinforcing for attached piers shall be as noted in Item 1 above with block-outs for metal fence post; typically.
3. Elevation 7/A5.1, provide 3 - #5 bars drilled and epoxy grouted into existing wall footing from new footing at pier. Provide block-outs in pier footings for metal fence post, typically.



**II. CONTENTS OF THIS ADDENDUM**

1. This Addendum consists of 1 page, and the following attachments.

Drawings 2-A1.1-1 and 2-A1.1-2, dated 2/13/09 and 8-1/2" x 11" in length.

**END OF ADDENDUM NO. 3**



W:\0807\ADDENDUMS\Addendum#3-021609.doc

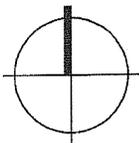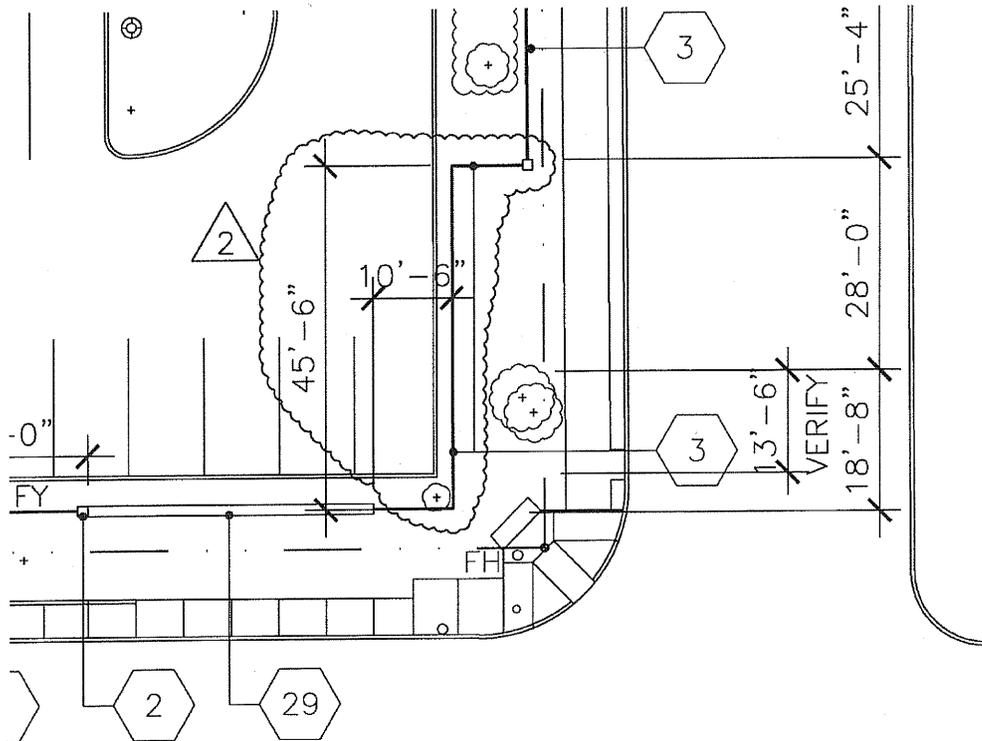

# ARCHITECTURAL SITE PLAN


SCALE: NTS

|  |   |   |   |
|--|---|---|---|
|  | <b>Rañon &amp; Partners, Inc.</b><br>Architects | <b>HILLSBOROUGH COUNTY SHERIFF'S OPERATIONS CENTER</b><br><b>SECURITY WALL / FENCING</b><br><b>AND GUARDHOUSE</b><br>TAMPA, FLORIDA | DWG.<br><b>2-A1.1-1</b><br>DATE: 02.13.09 |
|--|---|---|---|

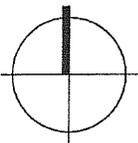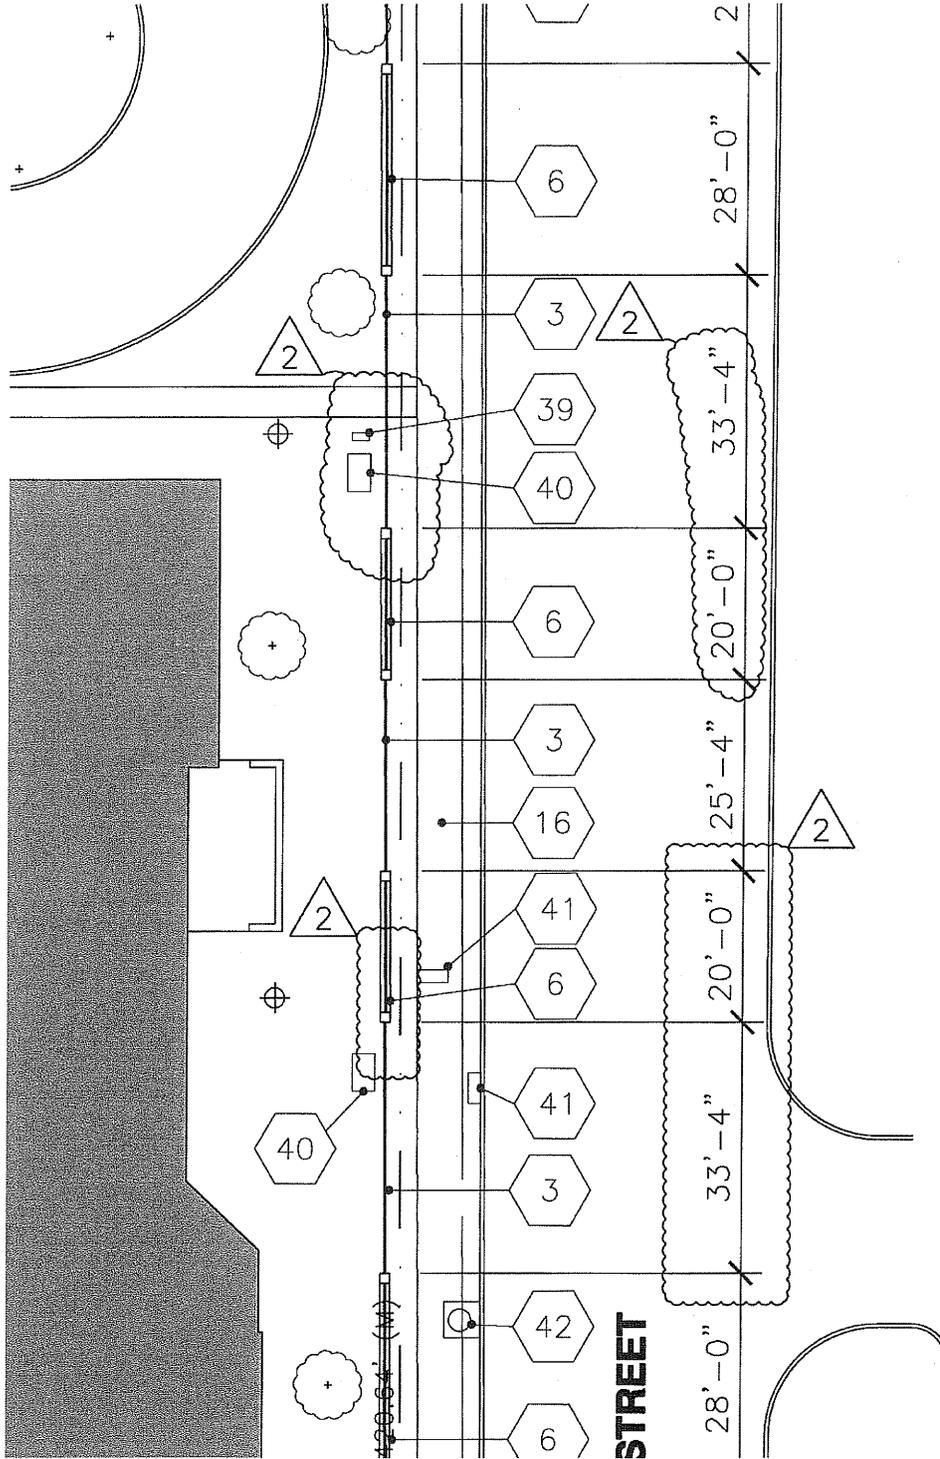

# ARCHITECTURAL SITE PLAN

SCALE: NTS

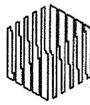
**Rañon & Partners, Inc.**  
 Architects

**HILLSBOROUGH COUNTY SHERIFF'S OPERATIONS CENTER**  
**SECURITY WALL / FENCING**  
**AND GUARDHOUSE**  
 TAMPA, FLORIDA

DWG.  
**2-A1.1-2**  
 DATE: 02.13.09

ADDENDUM NUMBER 3

ACKNOWLEDGEMENT OF ADDENDUM

We do hereby acknowledge the above changes to RFP No. 24.08:

PLEASE PRINT - Company Name \_\_\_\_\_

By \_\_\_\_\_

Title \_\_\_\_\_

Date \_\_\_\_\_

Phone \_\_\_\_\_

Signature \_\_\_\_\_